
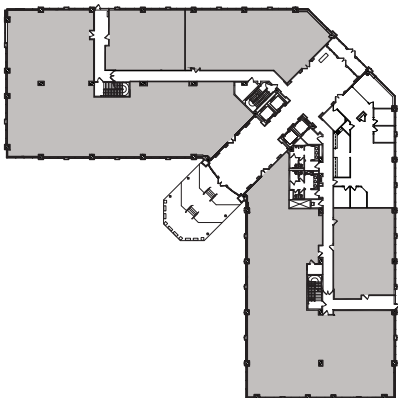


### Suite 150

As-Built      3,112 Sq. Ft.

\* Dimensions are Deemed as Accurate but not to Scale

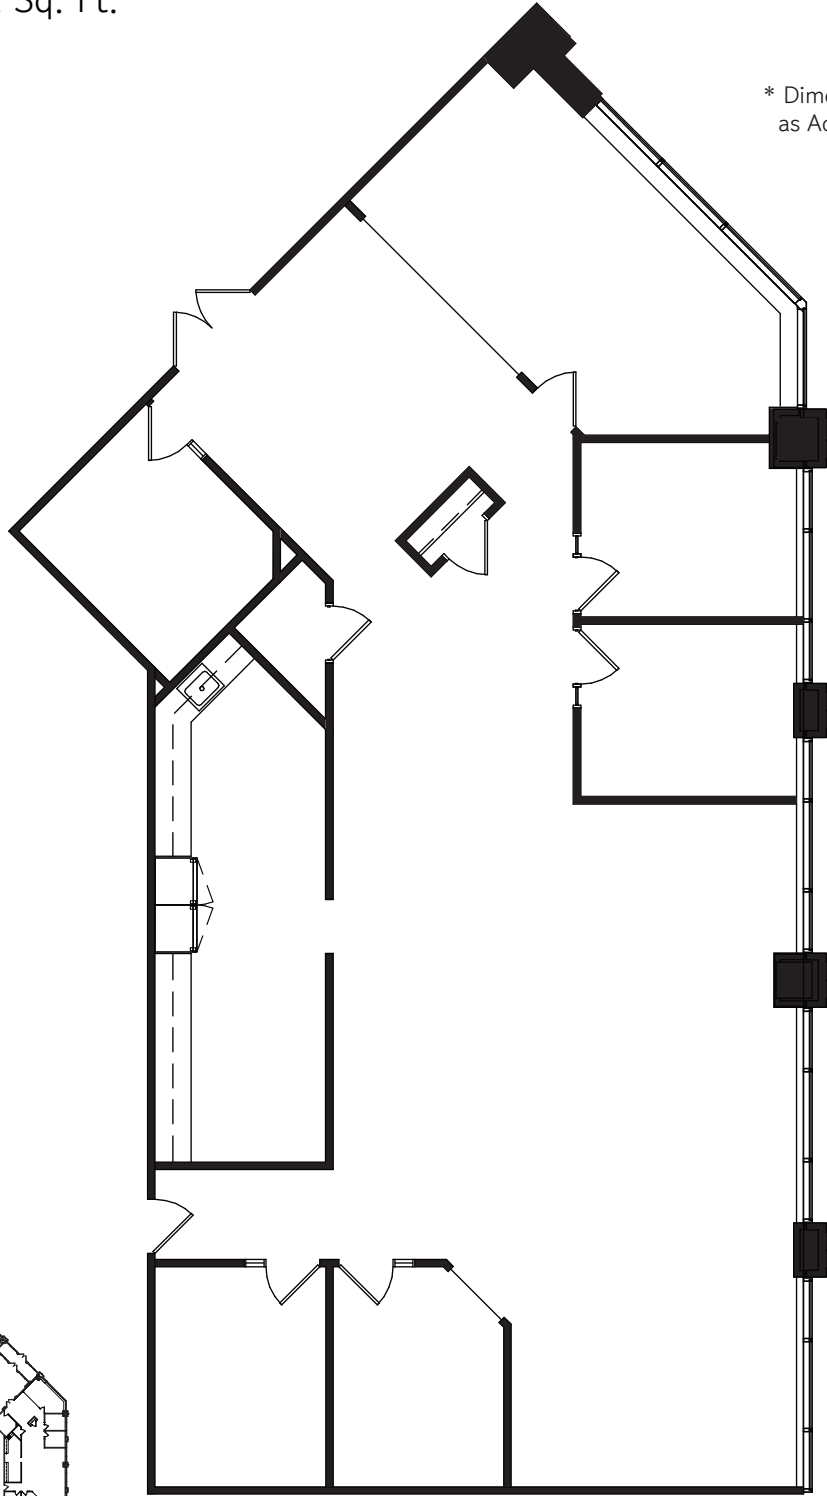

OWNED & MANAGED BY



LEASED BY

