
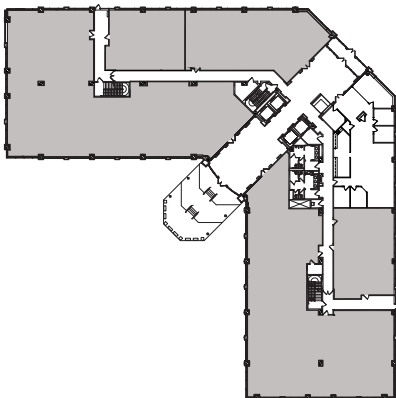


Suite 150

As-Built

3,112 Sq. Ft.

* Dimensions are Deemed as Accurate but not to Scale

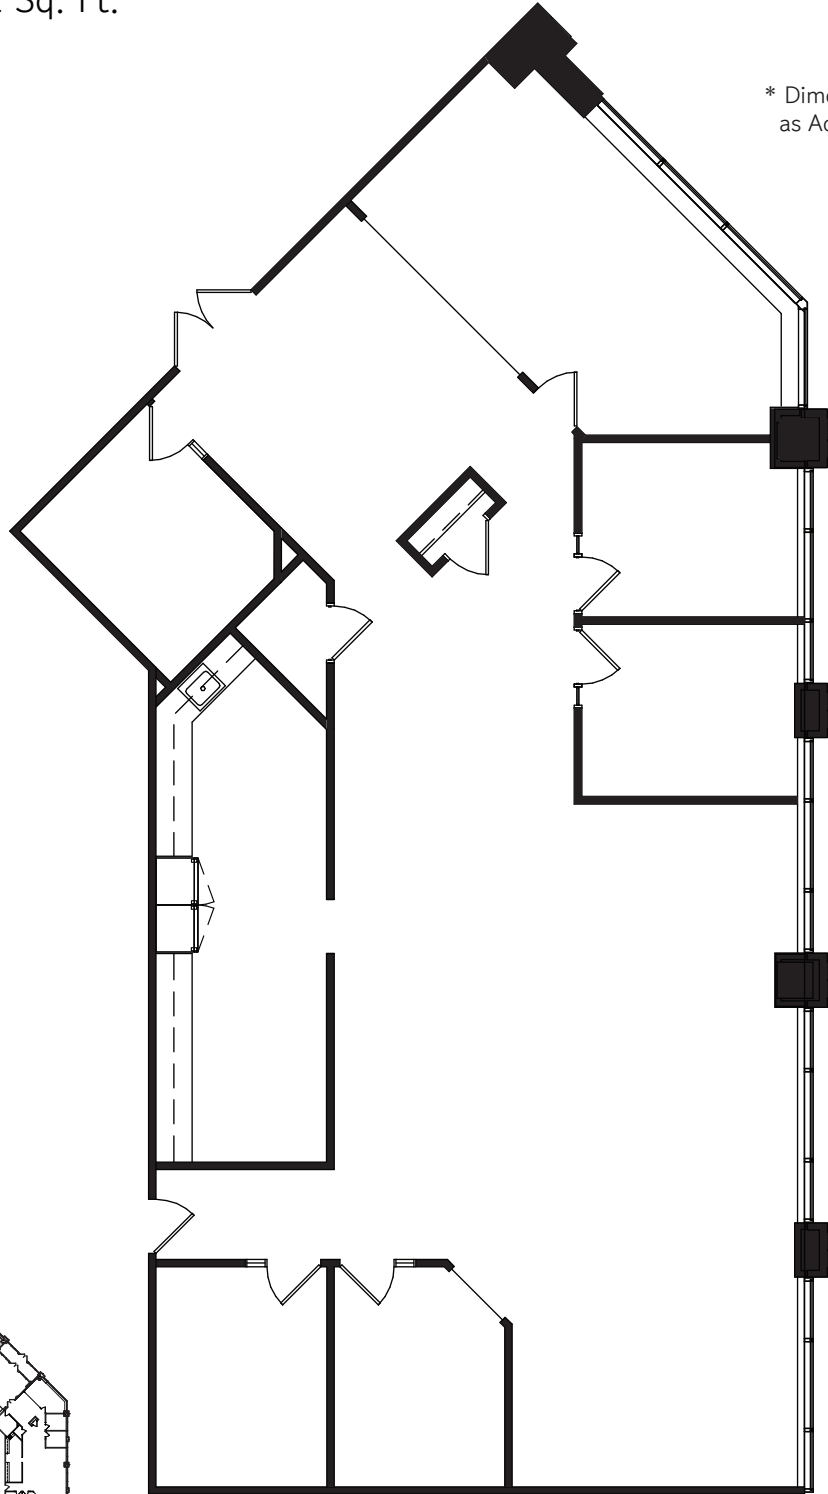

OWNED & MANAGED BY



LEASED BY

