



Suite 425

As-Built 2,959 Sq. Ft.

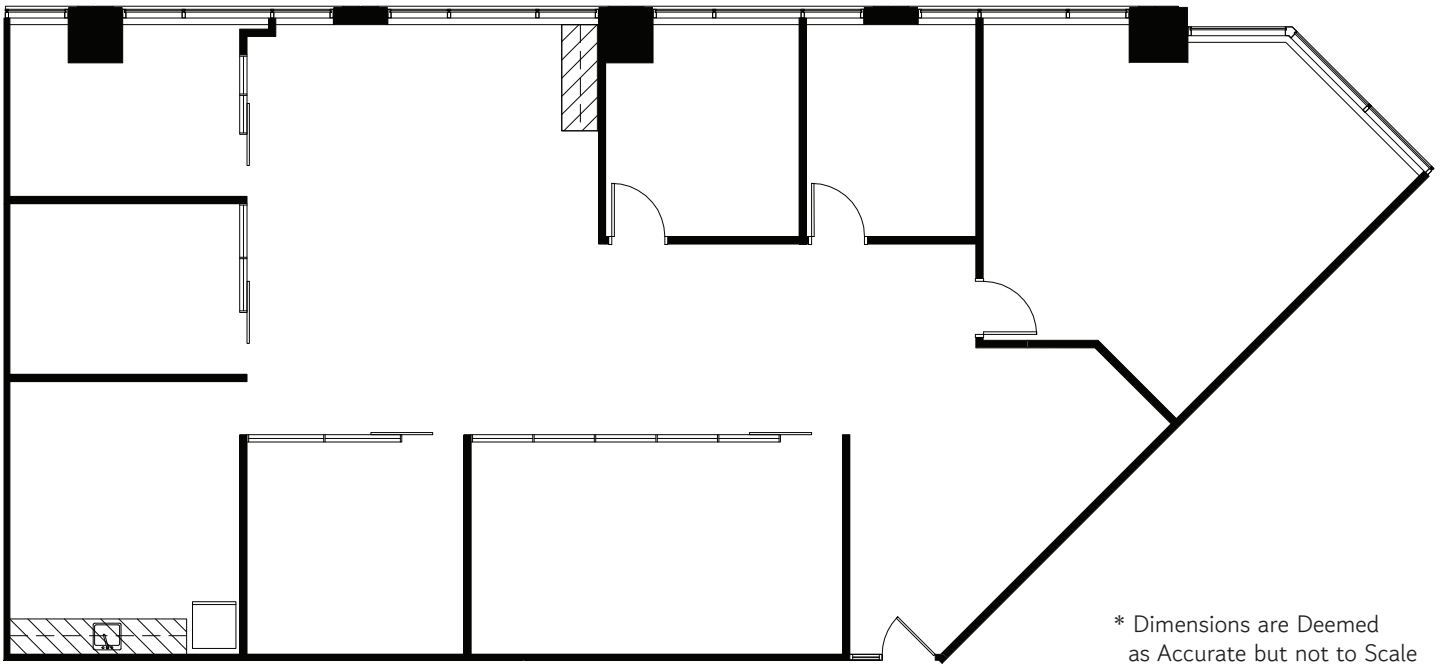

* Dimensions are Deemed
as Accurate but not to Scale

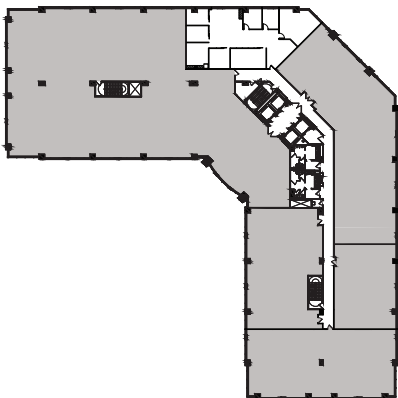

OWNED & MANAGED BY



LEASED BY

