
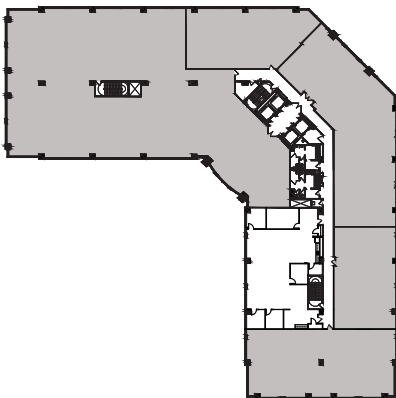


Suite 485

As-Built

3,611 Sq. Ft.

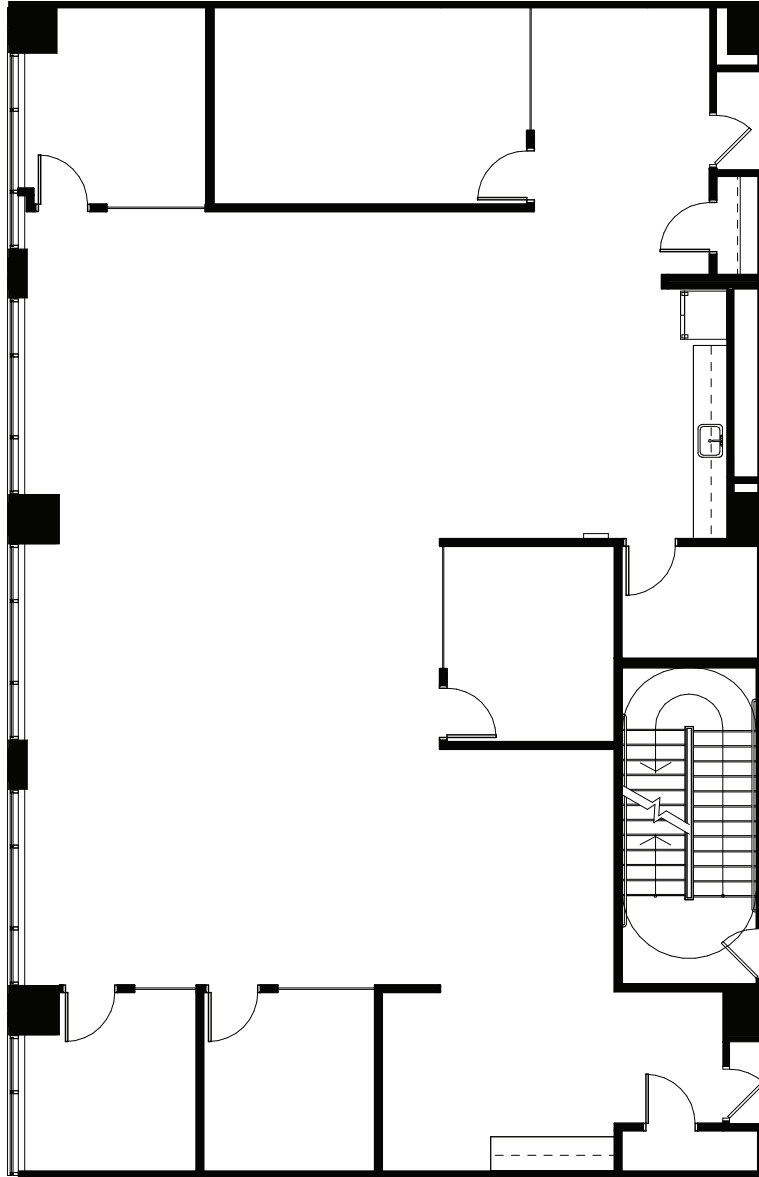

\* Dimensions are Deemed as Accurate but not to Scale

OWNED & MANAGED BY



LEASED BY

