
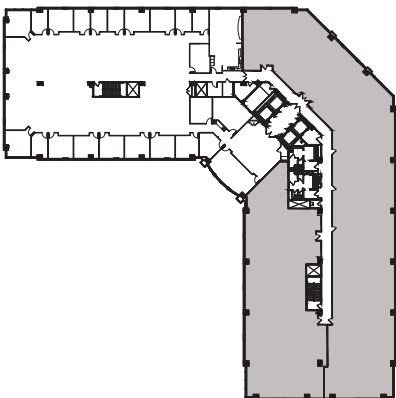


Suite 500

As-Built

14,681 Sq. Ft.

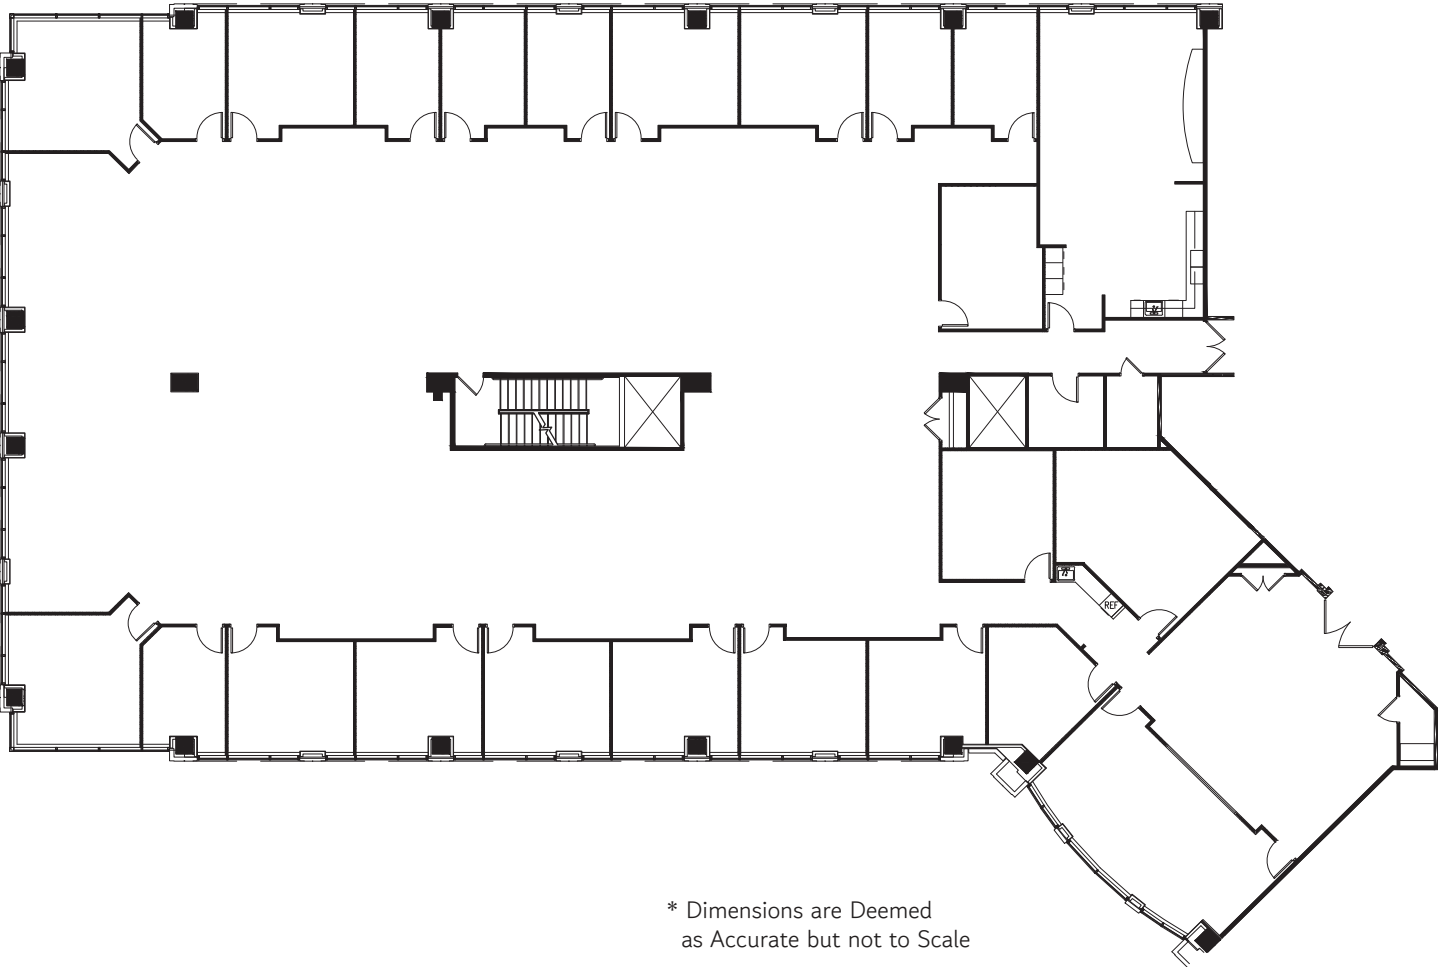

OWNED & MANAGED BY



LEASED BY

