



### Suite 575

As-Built      7,808 Sq. Ft.

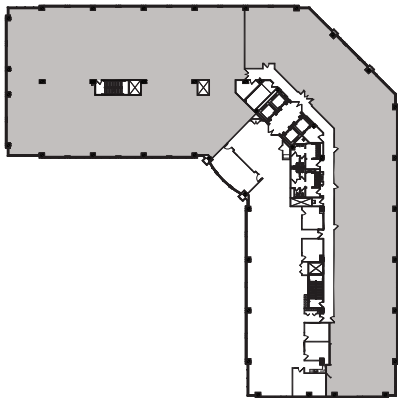

OWNED & MANAGED BY

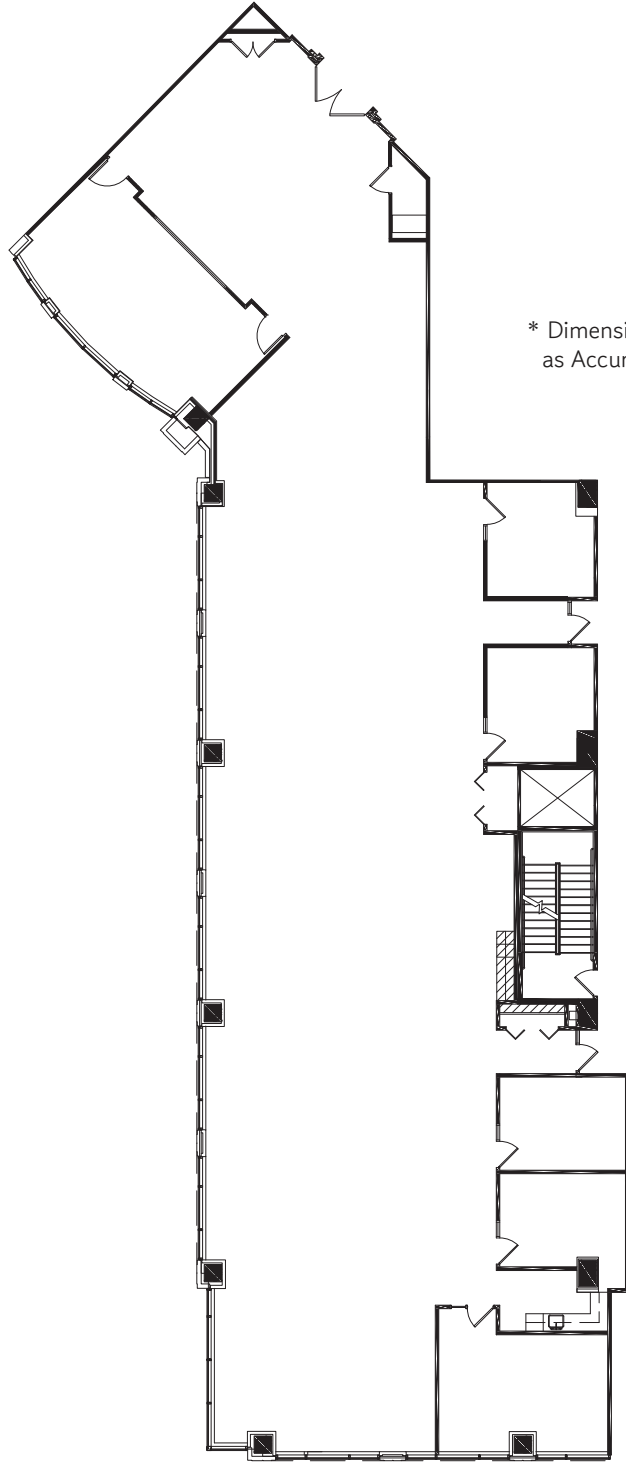

LEASED BY

