



Suite 650

As-Built 11,223 Sq. Ft.

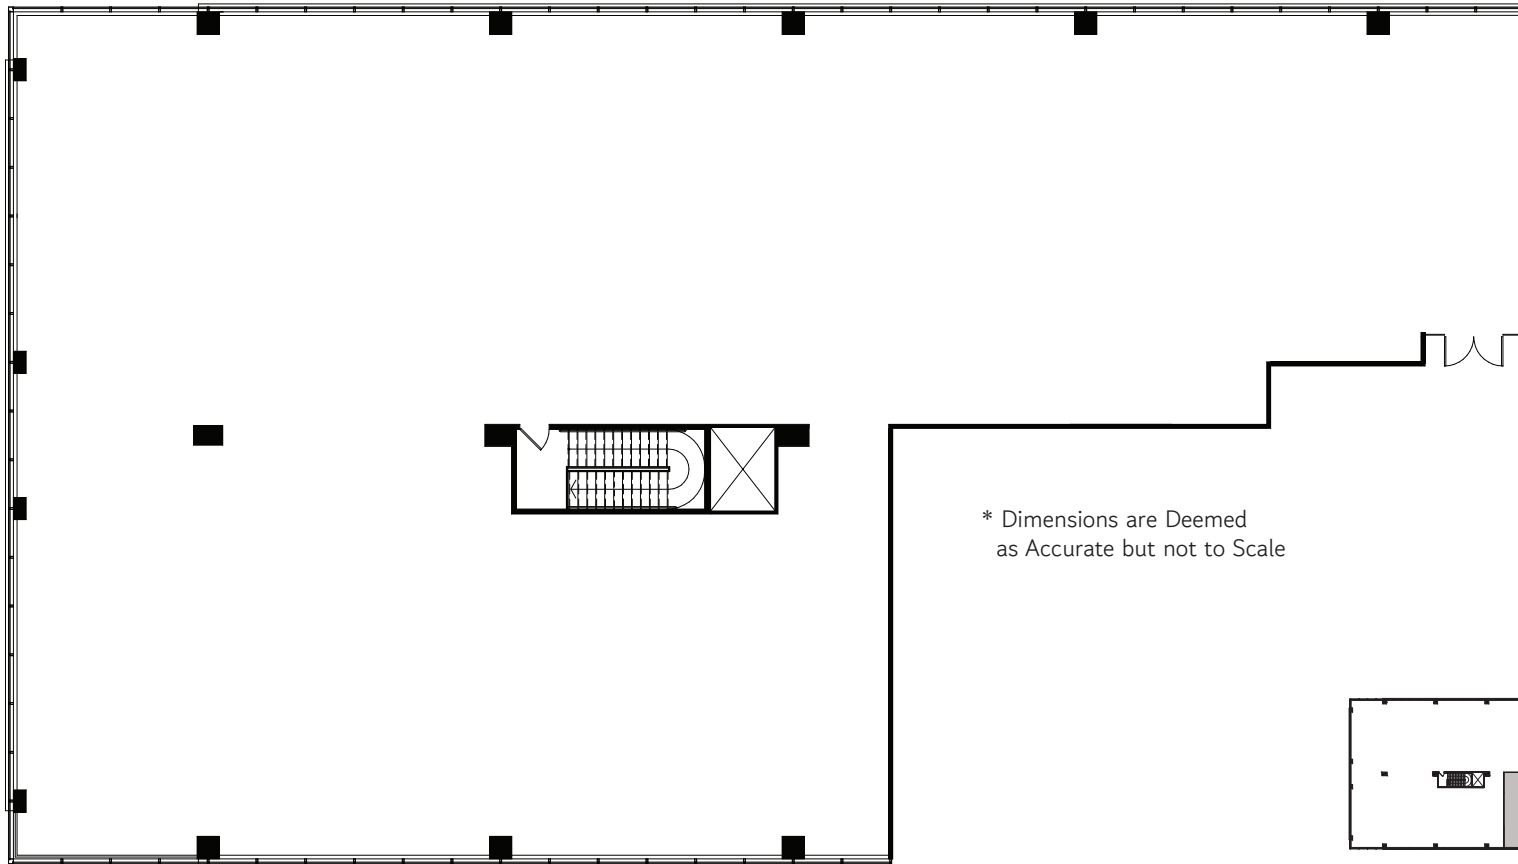

* Dimensions are Deemed as Accurate but not to Scale

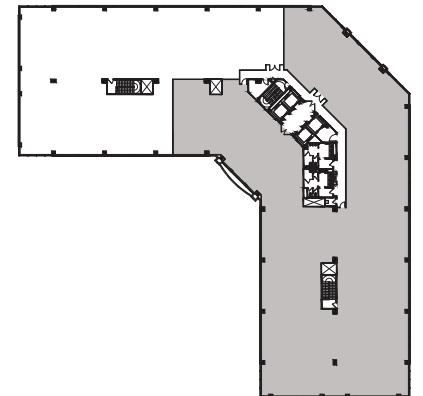

OWNED & MANAGED BY



LEASED BY

