
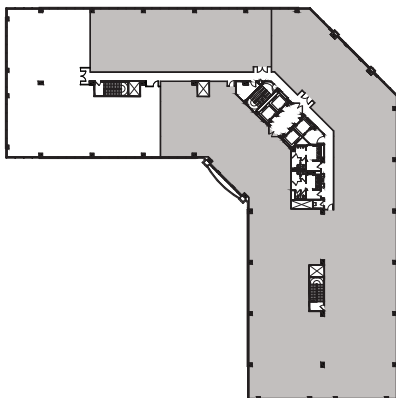


Suite 650

As-Built 6,808 Sq. Ft.

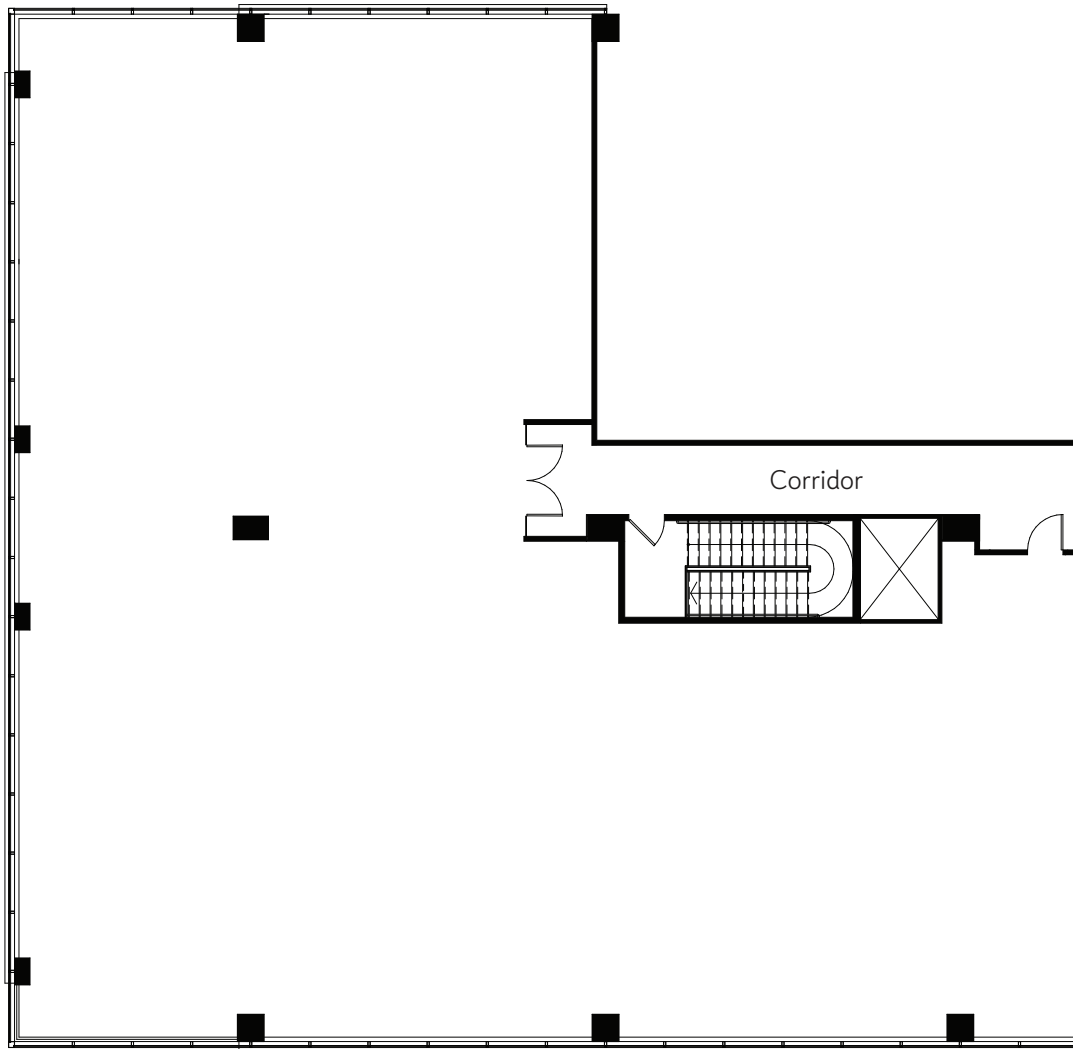

* Dimensions are Deemed
as Accurate but not to Scale

OWNED & MANAGED BY



LEASED BY

