

GOLDENHILLS

Suite 240

As-Built 3,295 Sq. Ft.

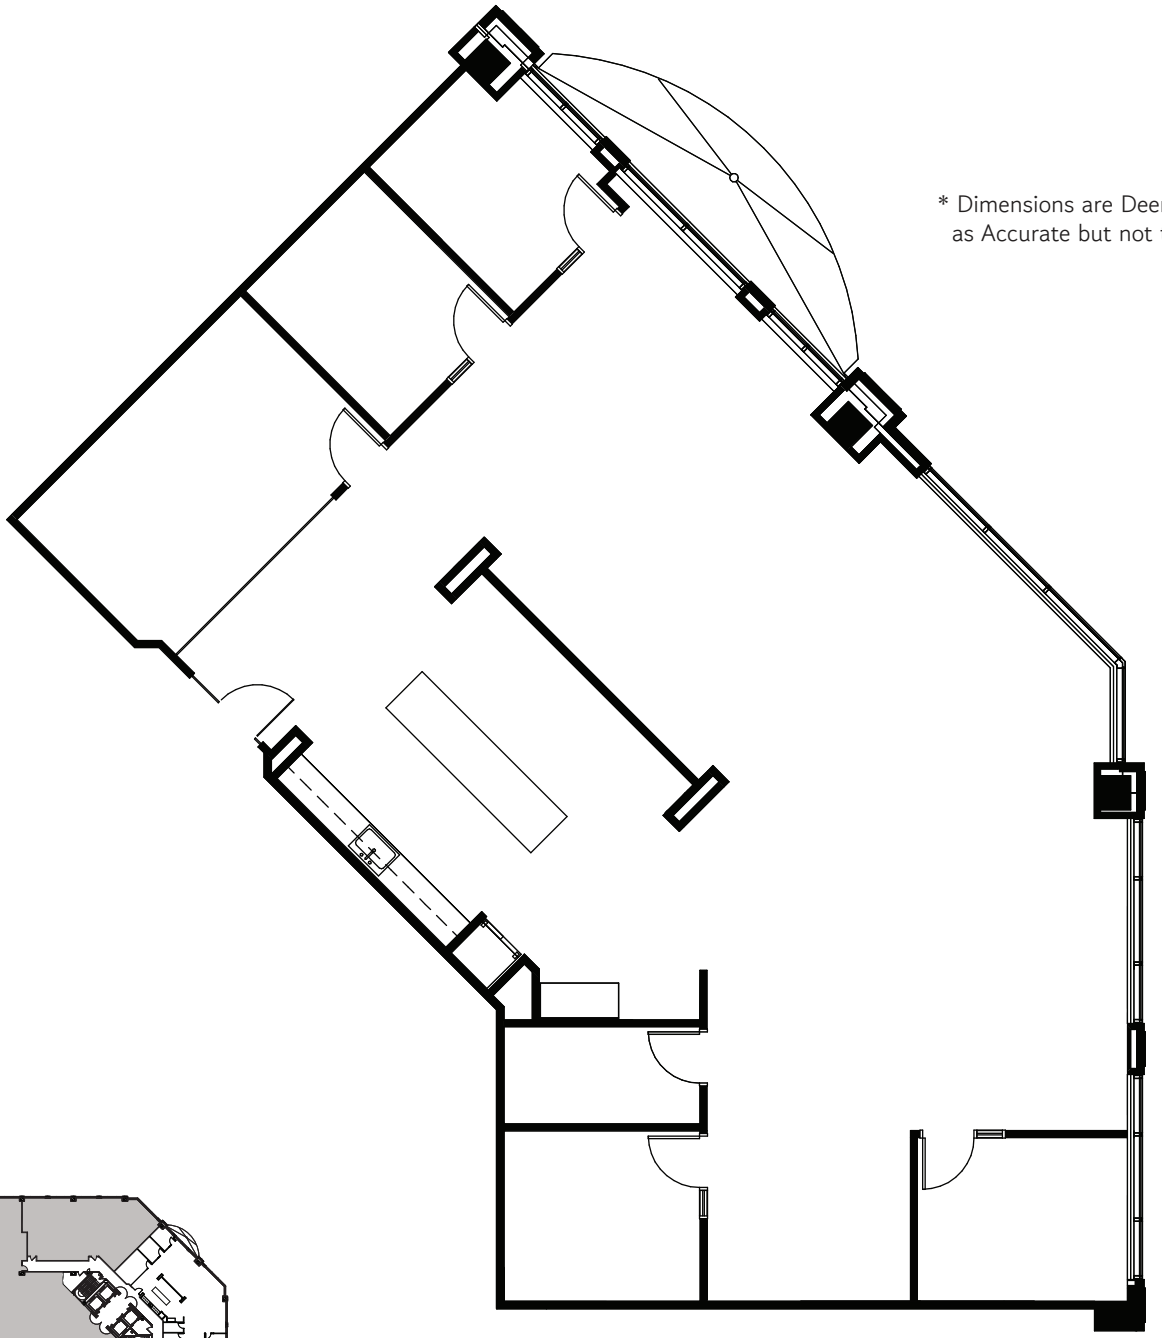

* Dimensions are Deemed as Accurate but not to Scale

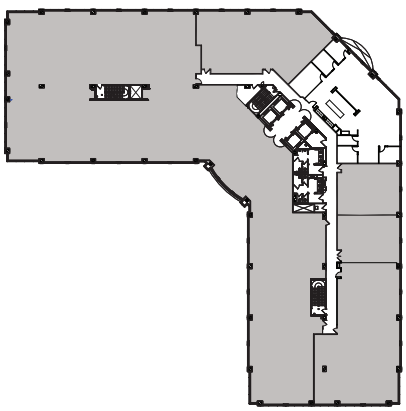

OWNED & MANAGED BY ALTUS

LEASED BY JLL