

GOLDENHILLS

Suite 410

As-Built 4,741 Sq. Ft.

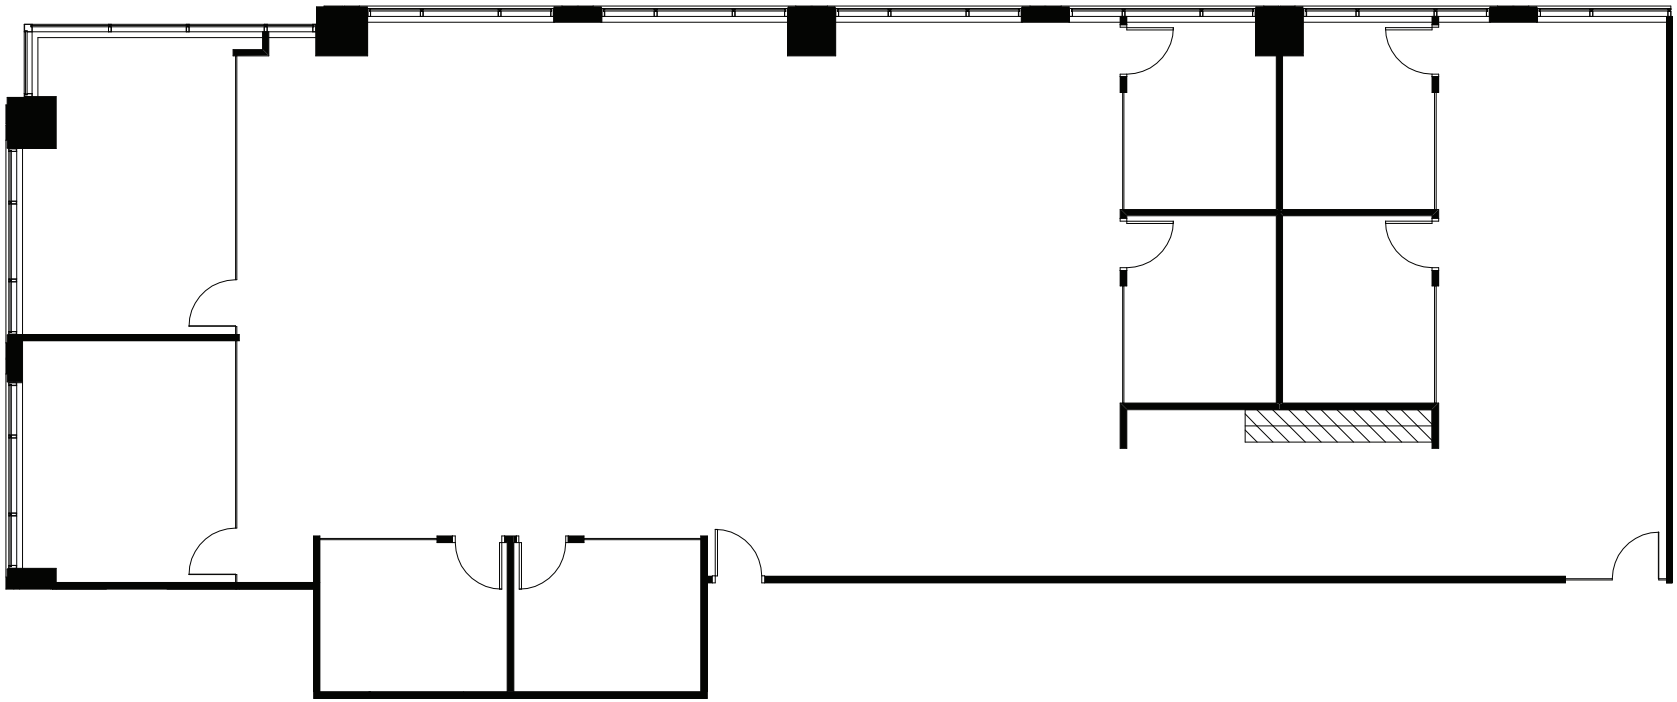

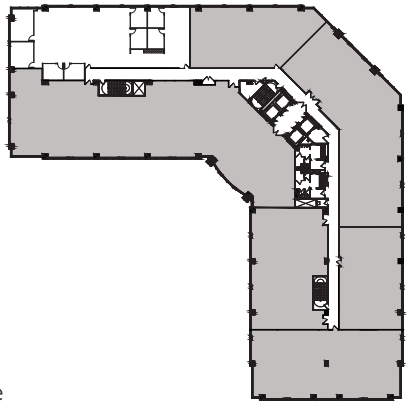

OWNED & MANAGED BY

ALTUS

LEASED BY

JLL®

* Dimensions are Deemed as Accurate but not to Scale