

GOLDENHILLS

Suite 575

As-Built 5,248 Sq. Ft.

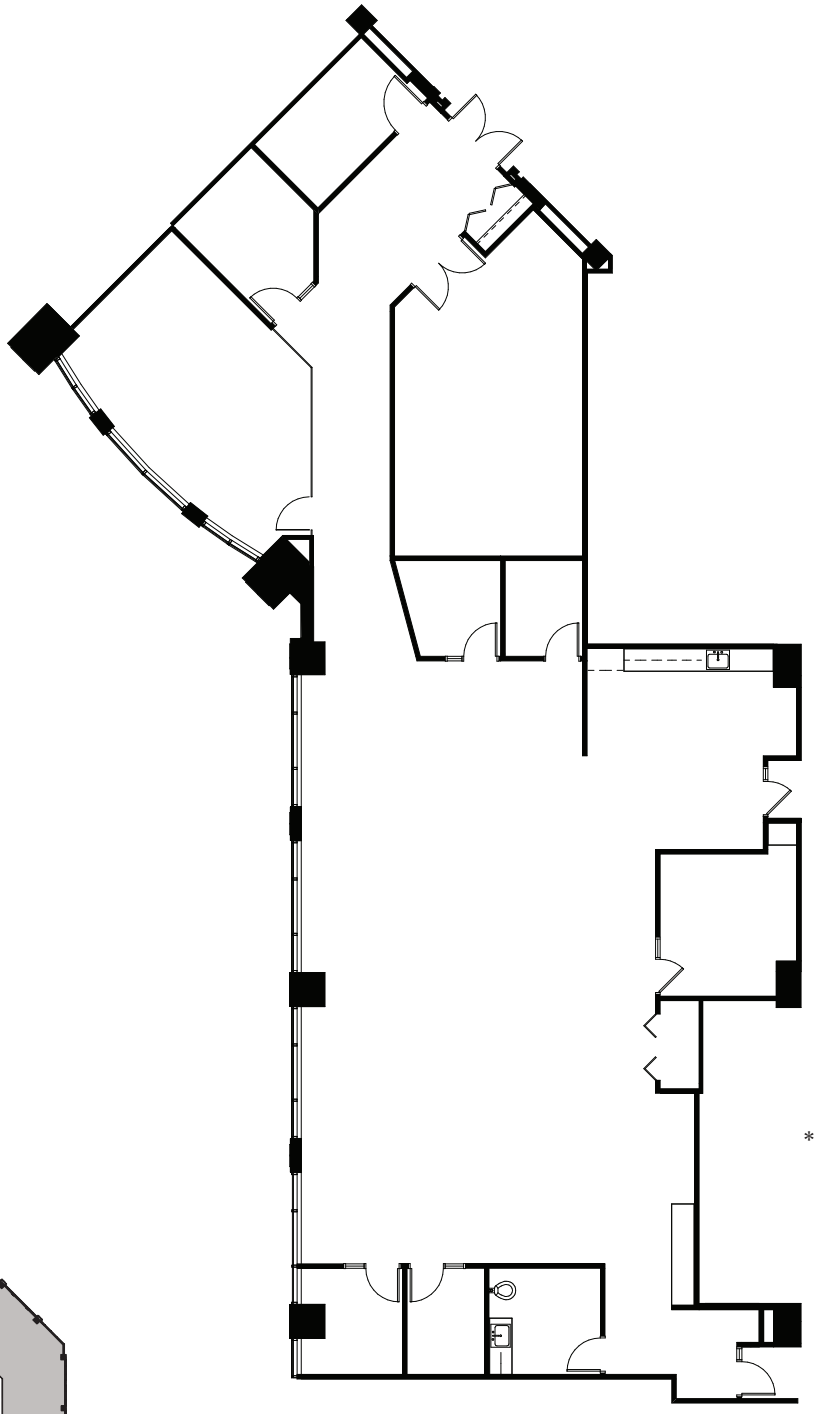

* Dimensions are Deemed as Accurate but not to Scale

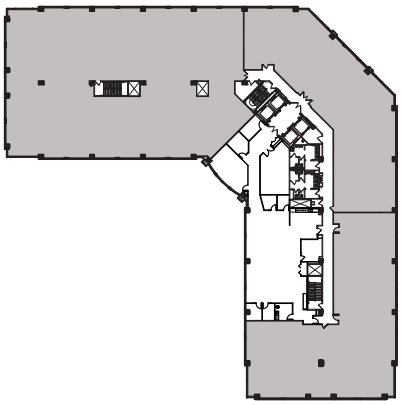

OWNED & MANAGED BY ALTUS

LEASED BY JLL