

GOLDENHILLS

Suite 675

As-Built 1,706 Sq. Ft.

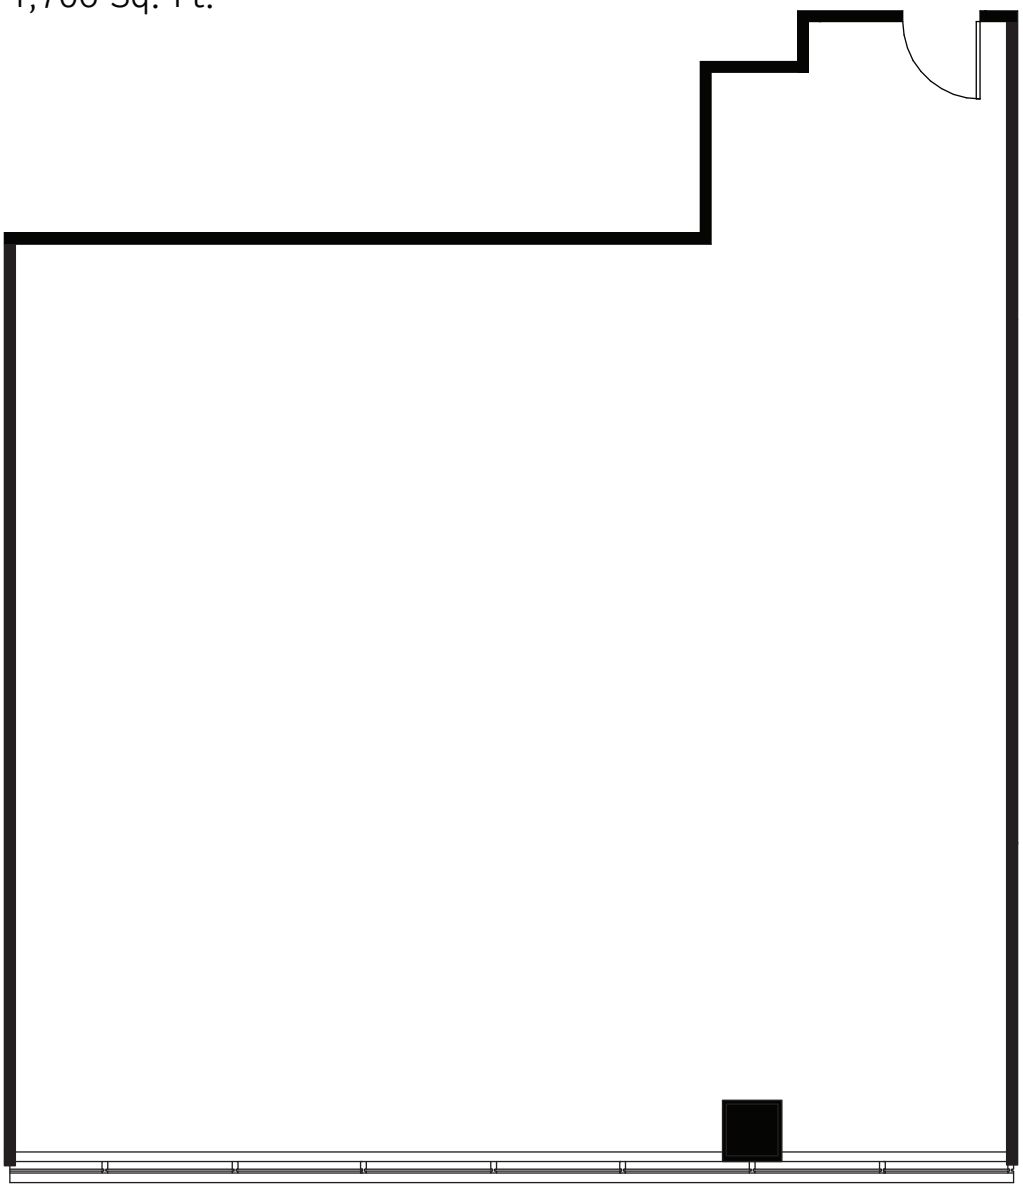

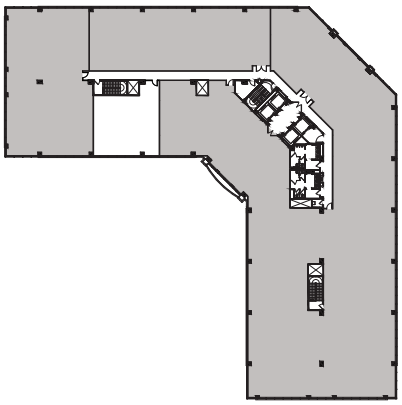

* Dimensions are Deemed as Accurate but not to Scale

OWNED & MANAGED BY ALTUS

LEASED BY JLL